

83-1030

State of Alaska
Department of Fish and Game
Public Review Nomination for Waters
Important to Anadromous Species

X Addition

Deletion

Name of Waterbody (if known): See map (10) 103-40-10250

Location:

Anadromous Waters Catalog Volume and Number Southeast 1

USGS 1:63,360 Quadrangle Craig A-3

or 1:250,000 (if 1:63,360 not available) _____

Species	Date(s) Observed	Stage(s) (Spawning, Rearing, Migration)
<u>Coho</u>	<u>81-82</u>	<u>m, S, R</u>
<u>Pink</u>	<u>81-82</u>	<u>m, S</u>


Comments: Please provide any clarifying information. Also, please include a map of the area identifying the stream reach. This can be a copy of the map from the Anadromous Waters Atlas.

Name of Observer (please print) Don House


Date: 3/7/83 Signature: Don House

4/3/83

Address: 415 Main St Rm 208
Ketchikan, Alaska 99901

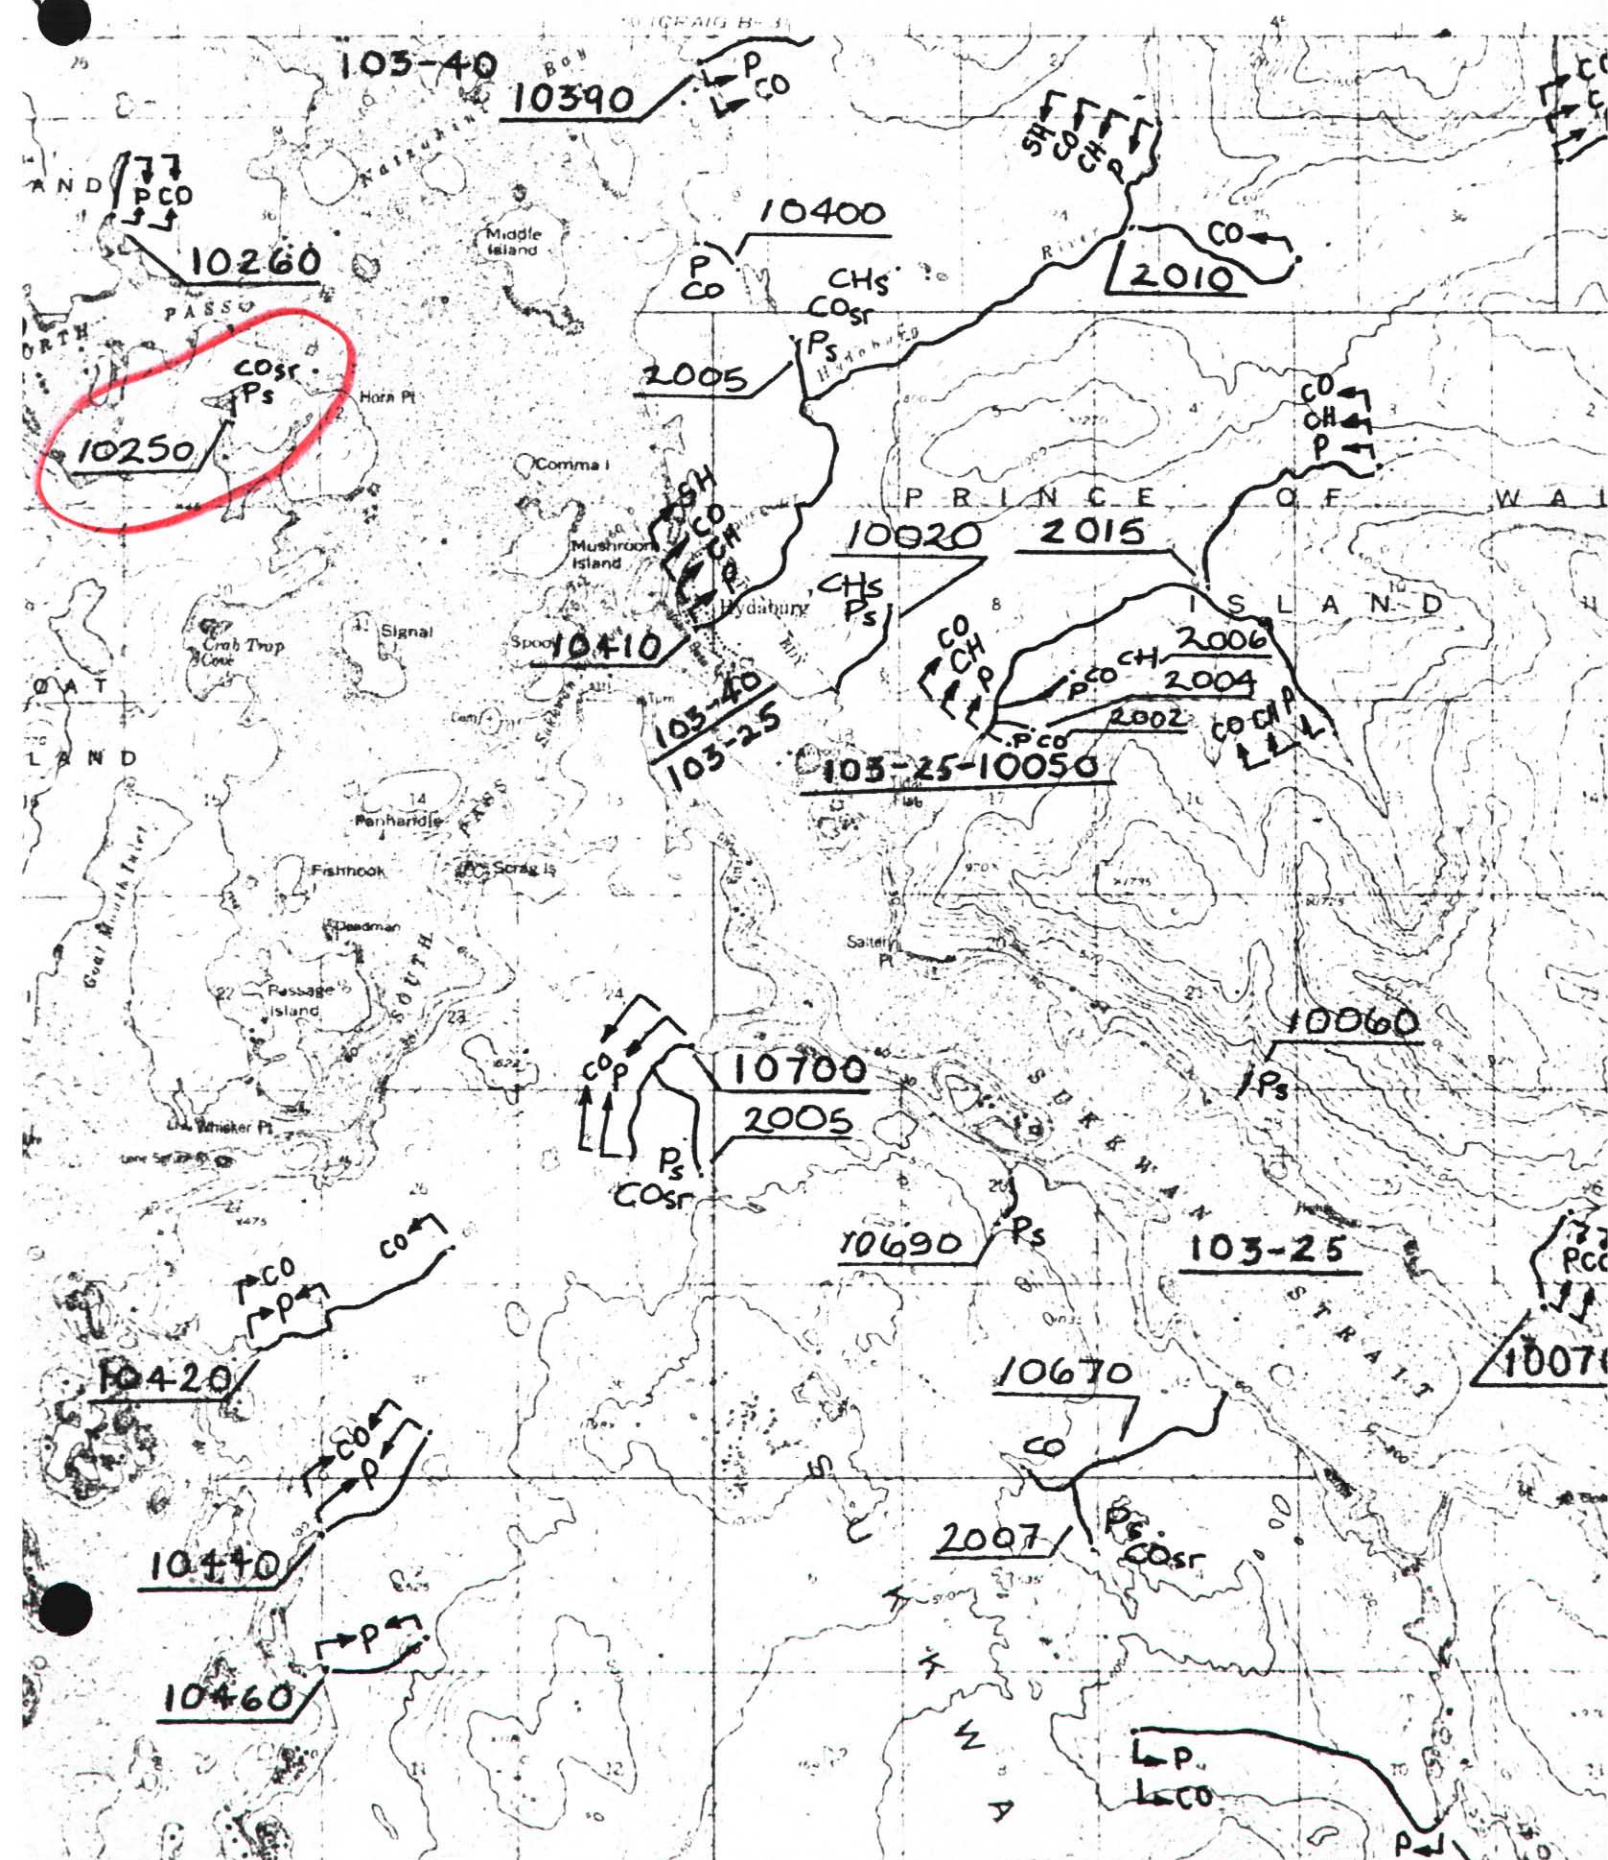

FINCL

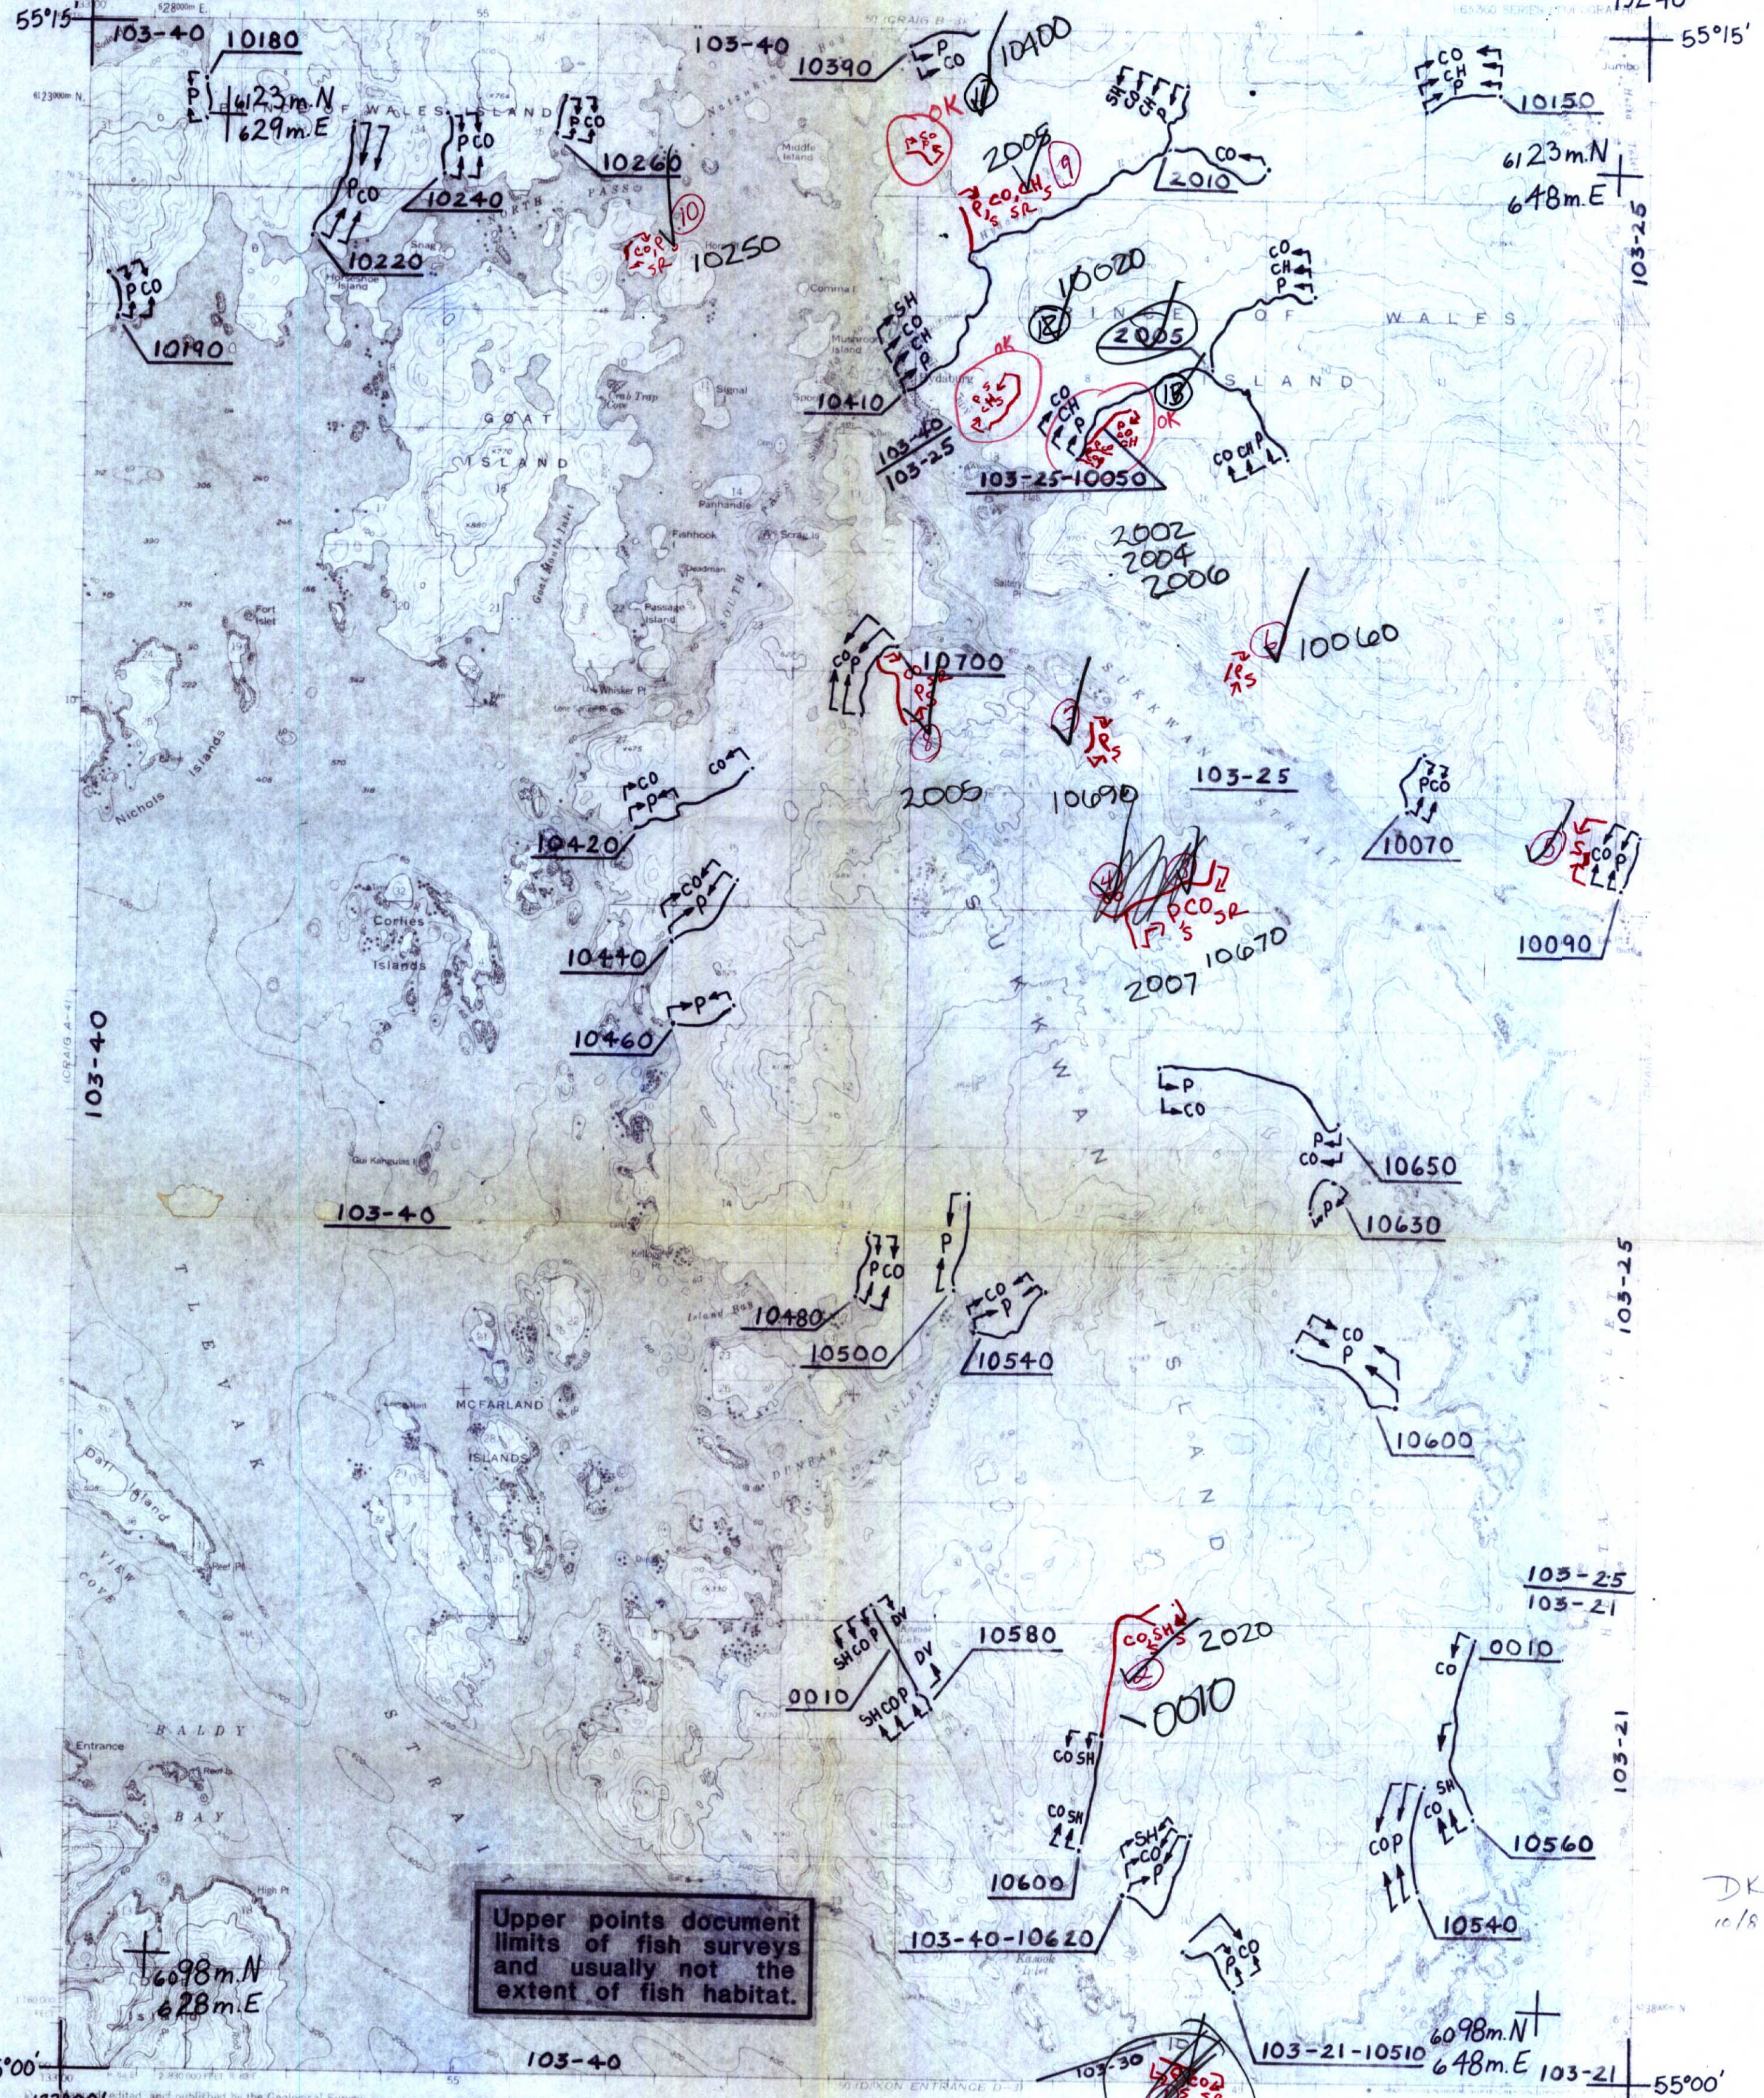

Upper points document
limits of fish surveys
and usually not the
extent of fish habitat.

Topography by photogrammetry, methods from aerial photographs
(aerial 1940; land 1950-1951). Map scale 1:50,000.
Selected hydrographic data from USCGS Charts
8147 (1957), 8148 (1952), and 8151 (1952). This information
is not intended for navigational purposes.
Universal Transverse Mercator projection, 1927 North American datum,
10,000 foot grid based on Alaska coordinate system, zone 1.
1000 metre Universal Transverse Mercator grid ticks,
contour interval 100 feet.
Land lines represent unsurveyed and unmarked locations
from computerized data by the State of Alaska, Division of Land,
Gasper River Meridian.
Entire land area is within the Tongass National Forest
except Hyaburg exclusion area.
Swamps as portrayed indicate only the wetter areas.
Unusually low relief as indicated from aerial photographs.
Lake elevations are indicated.



CONTOUR INTERVAL 100 FEET
NATIONAL COAST AND GEODETIC SURVEY, FAIRBANKS, ALASKA
DEPTH SOUNDINGS IN FEET, METERS, AND FATHOMS
SHORELINE DATA FROM 1911 TO 1951, AND 1951 TO 1957
THE HIGHEST ELEVATION OF A MOUNTAIN IS 1000 FEET

FOR SALE BY U.S. GEOLOGICAL SURVEY
FAIRBANKS, ALASKA 99701 DENVER, COLORADO 80225 OH RESTON, VIRGINIA 22092
A FOLDER DESCRIBING TOPOGRAPHIC MAPS AND SYMBOLS IS AVAILABLE ON REQUEST

MAP NO.
A-3
OF
3

LEGEND	
S Sockeye Salmon	Subscript
K King Salmon	s- Known Spawning
CO Coho Salmon	r- Rearing
P Pink Salmon	m- Migration
CH Chum Salmon	
SH Steelhead Trout	
DV Dolly Varden	
AC Arctic Char	
SF Sheefish	
W Whitefish	
C Cutthroat Trout	

COMP.	DRC
DRAWN	CD
REVISED	DRC
APPROVED	ERL
DATE	4/82
FILE NO.	

SCALE
1" = 1 MILE
1 : 63,360

PROJ. TITLE
ANADROMOUS STREAM CATALOG
ANADROMOUS WATERS ARE LISTED PURSUANT TO AS 16.05.870 (a)
MAP TITLE
CRAIG A-3



STATE OF ALASKA
DEPARTMENT OF FISH AND GAME
habitat protection division
JUNEAU, ALASKA

BY	DATE
PSJ	6/81
K. Haver	6/10/81
RD	4/7-83
REVISIONS	